

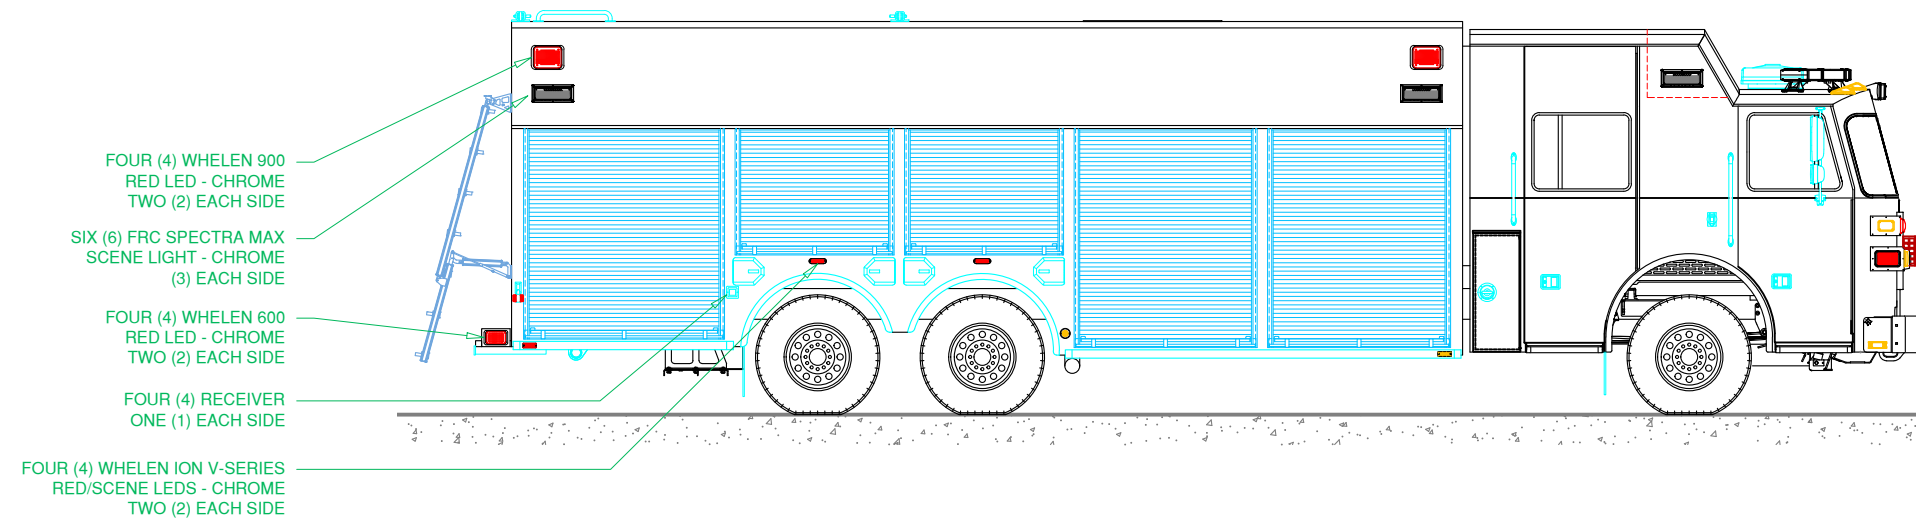
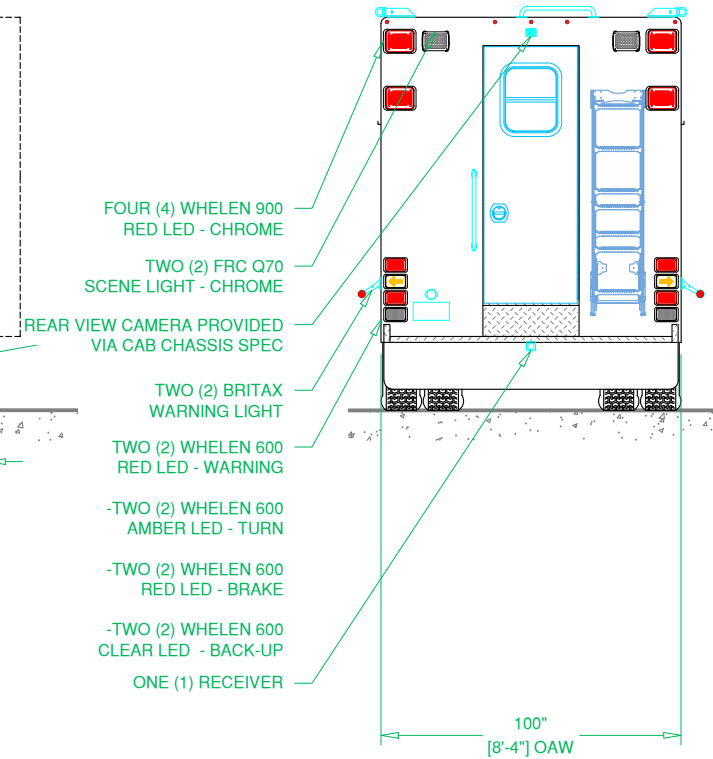
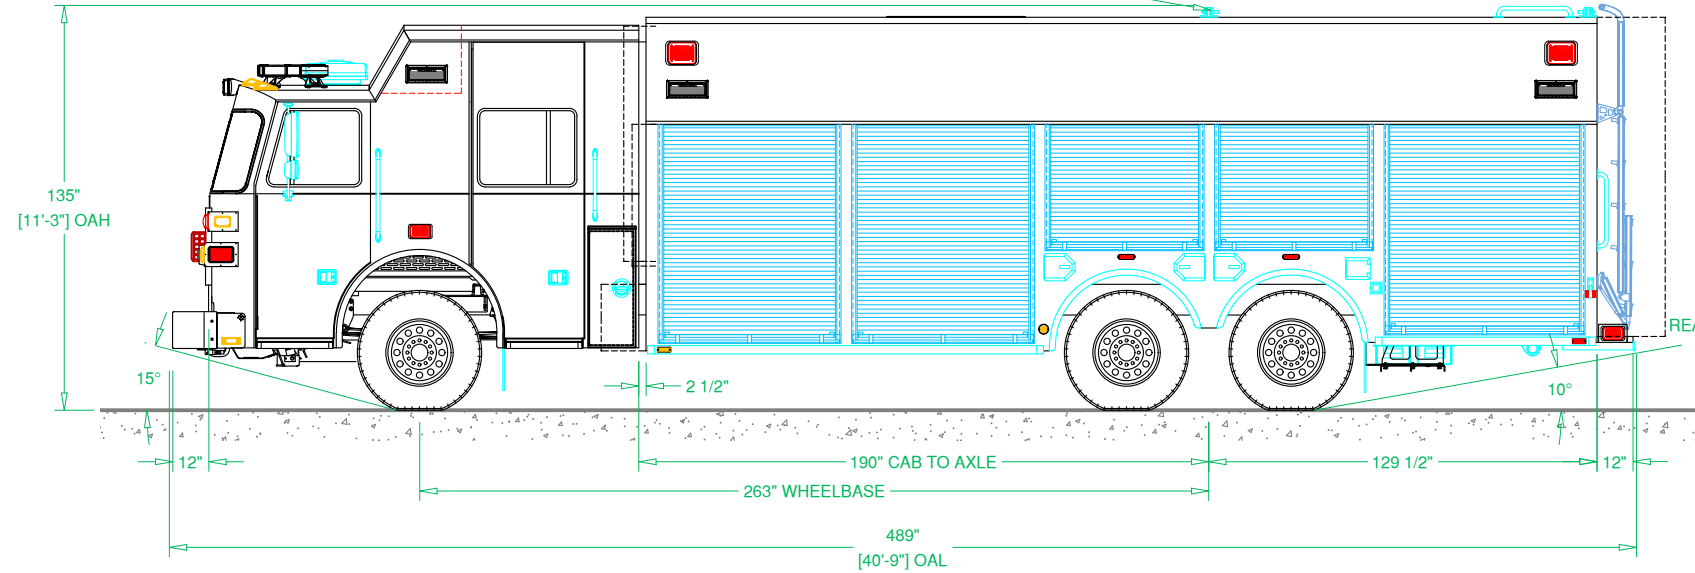



REVISIONS			
REV	DESCRIPTION	DATE	BY

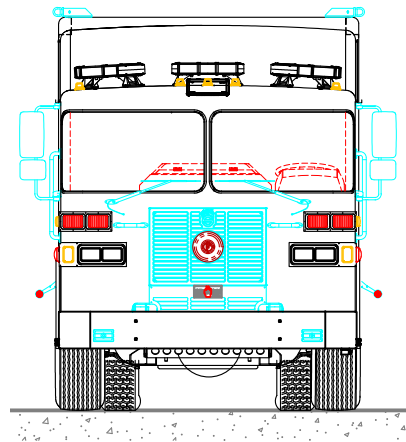

THIS PRINT IS PROVIDED ON A RESTRICTED BASIS AND IS NOT TO BE USED IN ANY WAY DETRIMENTAL TO THE INTEREST OF SUTPHEN CORPORATION.

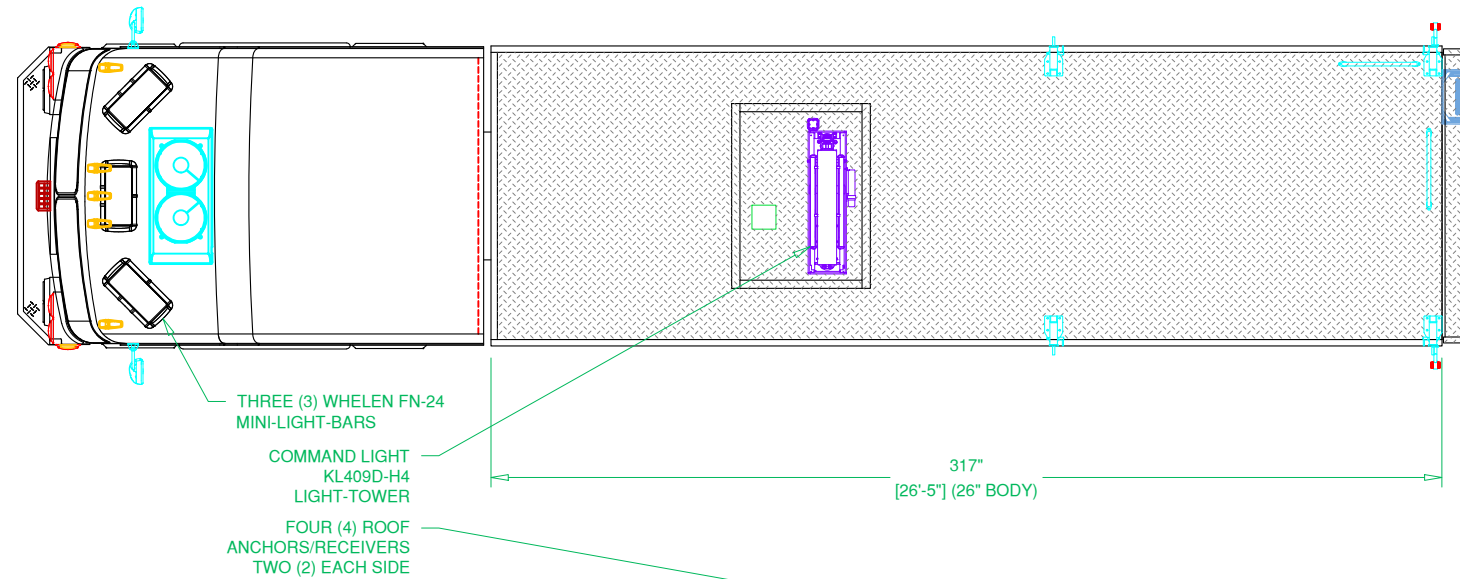





SUTPHEN CORPORATION
FIRE APPARATUS SINCE 1890
7000 COLUMBUS-MARYSVILLE ROAD
AMLIN, OHIO 43002

**ELKHART
FIRE DEPARTMENT**


BODY SIZE: 26' BODY	UNIT TYPE: HEAVY RESCUE / WALK-IN
BODY MATERIAL: 3/16" ALUMINUM	TRUCK NO: SVI #1216
CHASSIS TYPE: SUTPHEN	WHEELBASE: 263.00"
MONARCH 73"	CAB TO AXLE: 190.00"
20" RR	OVERALL LENGTH (OAL): 489.00"
FOUR DOOR	OVERALL WIDTH (OAW): 100.00"
	OVERALL HEIGHT (OAH): 135.00"

DRAWN BY: KP DATE: February 7, 2023 SCALE: 3/16" = 1'-0"
DRAWING NO: Elkhart IN wt 26 AsBuilt SHEET 1 OF 3

REVISIONS			
REV	DESCRIPTION	DATE	BY

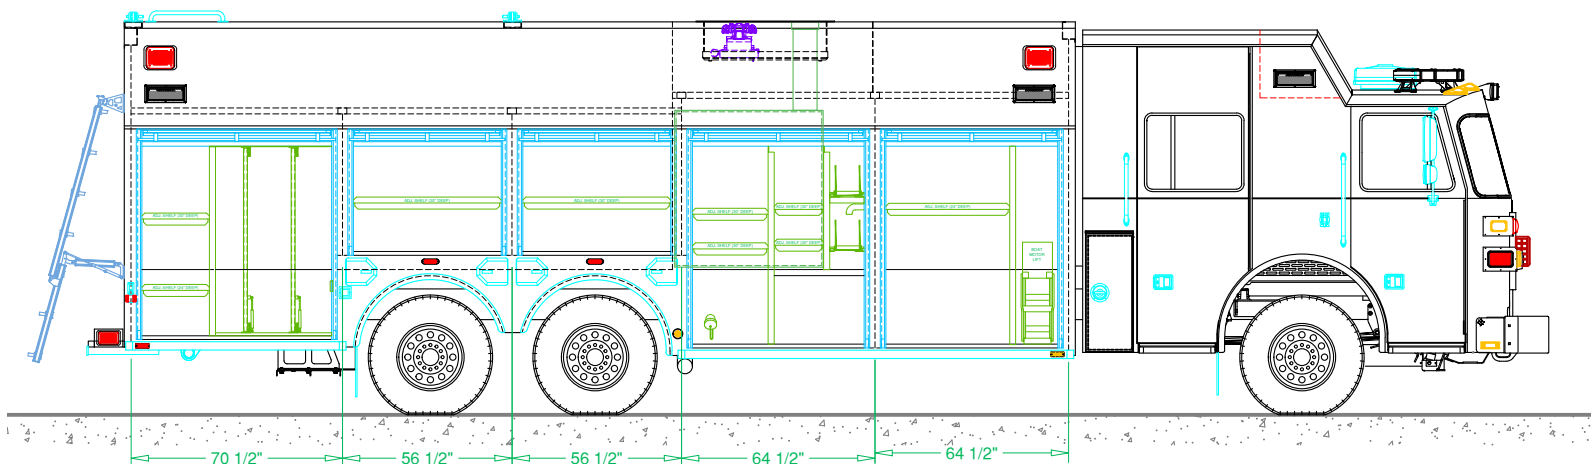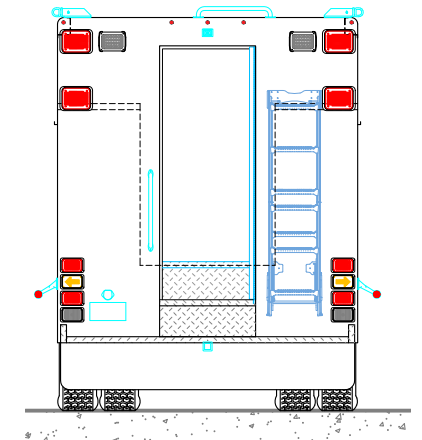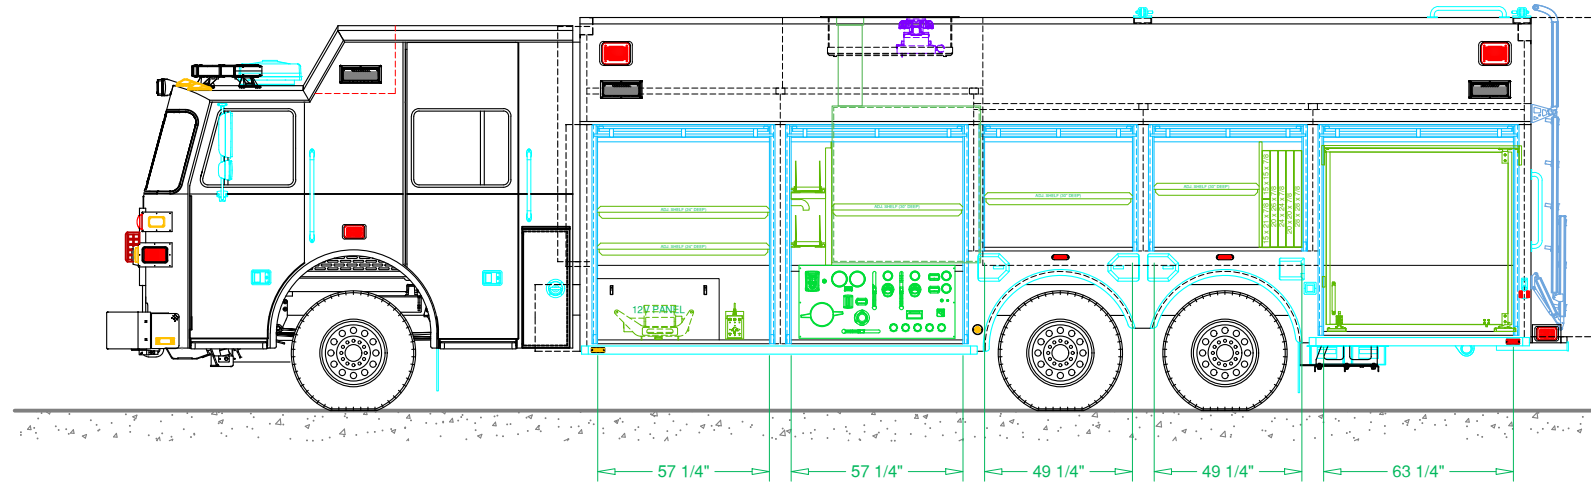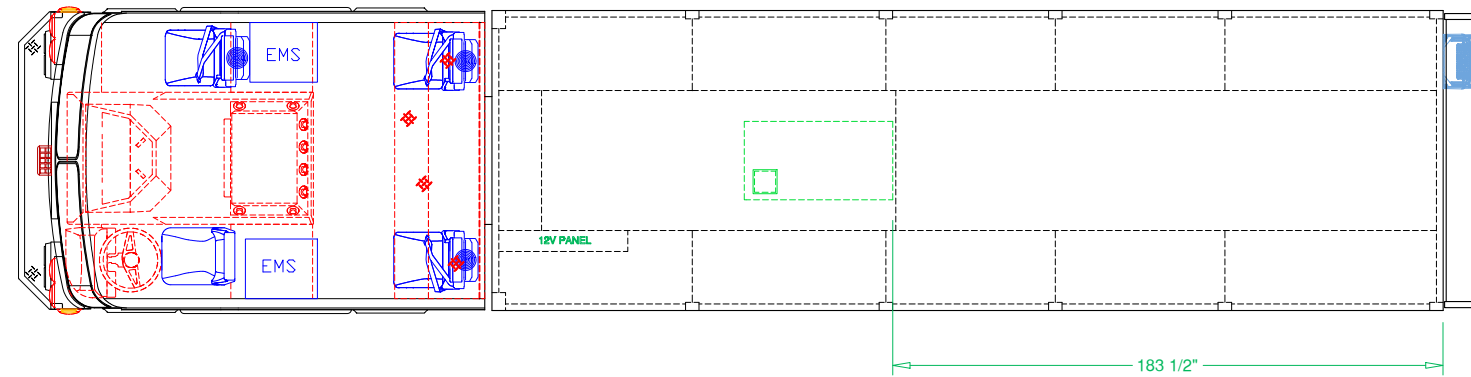

THIS PRINT IS PROVIDED ON A RESTRICTED BASIS AND IS NOT TO BE USED IN ANY WAY DETRIMENTAL TO THE INTEREST OF SUTPHEN CORPORATION.



SUTPHEN CORPORATION
 FIRE APPARATUS SINCE 1890
 7000 COLUMBUS-MARYSVILLE ROAD
 AMLIN, OHIO 43002

**ELKHART
 FIRE DEPARTMENT**


BODY SIZE: 26' BODY	UNIT TYPE: HEAVY RESCUE / WALK-IN
BODY MATERIAL: 3/16" ALUMINUM	TRUCK NO: SVI #1216
CHASSIS TYPE: SUTPHEN	WHEELBASE: 263.00"
MONARCH 73"	CAB TO AXLE: 190.00"
20" RR	OVERALL LENGTH (OAL): 489.00"
FOUR DOOR	OVERALL WIDTH (OAW): 100.00"
	OVERALL HEIGHT (OAH): 135.00"

DRAWN BY: KP DATE: February 7, 2023 SCALE: 3/16" = 1'-0"


DRAWING NO: Elkhart IN wt 26 AsBuilt SHEET 2 OF 3

REVISIONS			
REV	DESCRIPTION	DATE	BY


PLAN VIEW
CROSS-SECTION

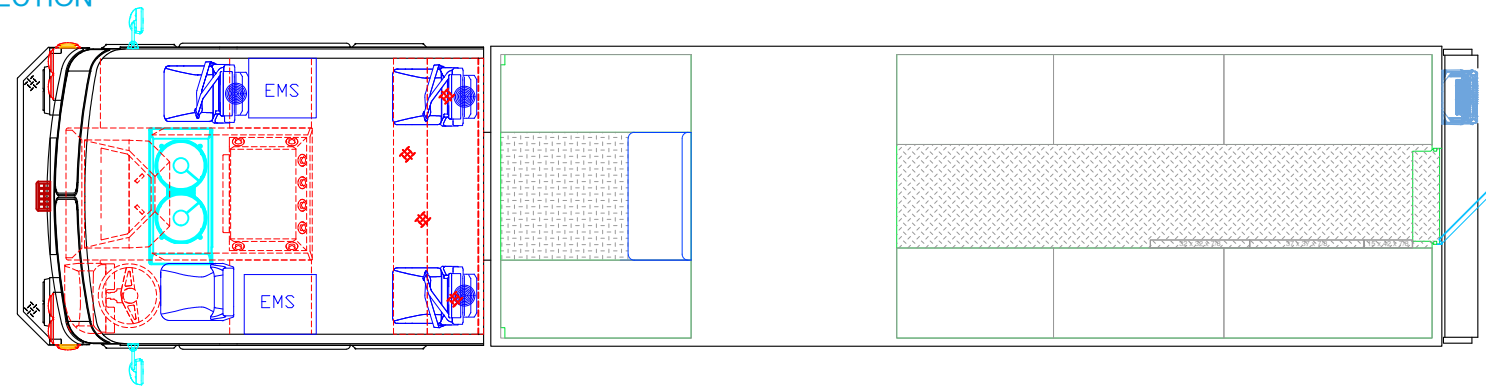

CURBSIDE INTERIOR
CROSS-SECTION

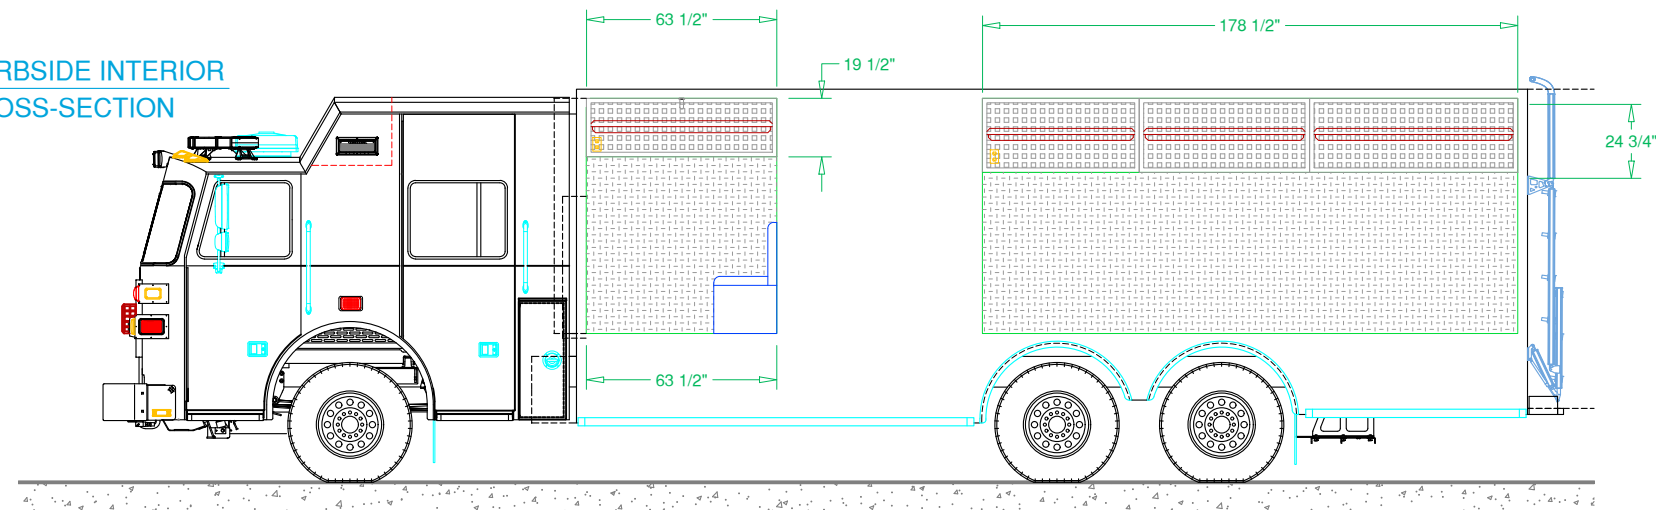

STREETSIDE INTERIOR
CROSS-SECTION

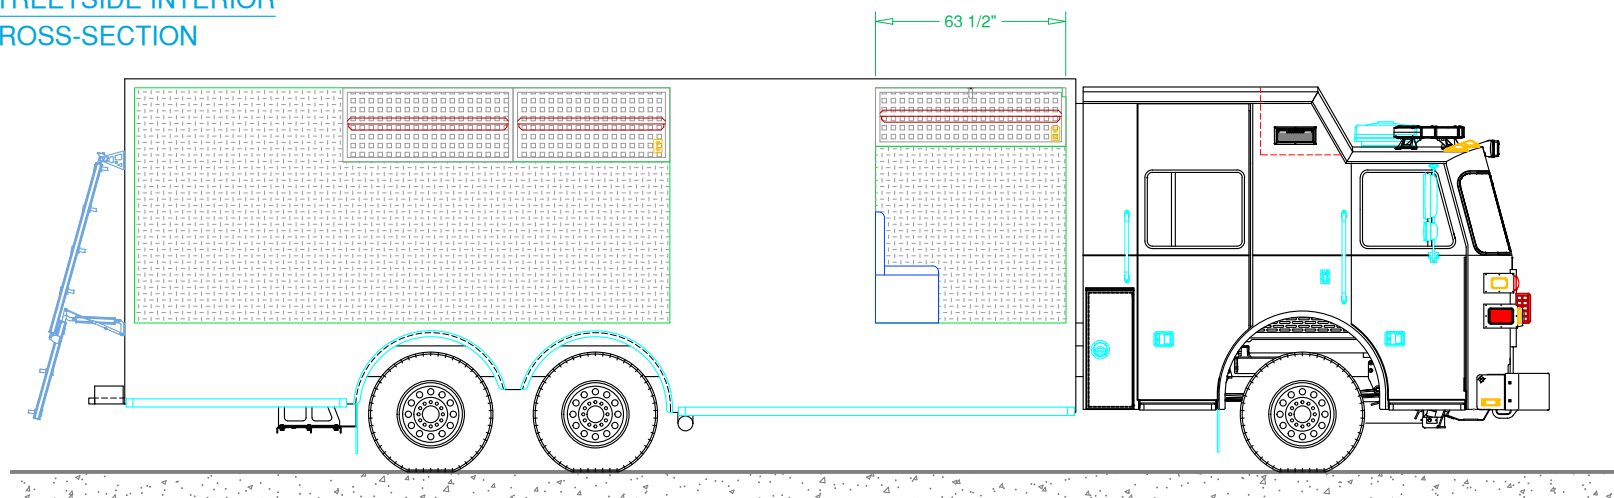

THIS PRINT IS PROVIDED ON A RESTRICTED BASIS AND IS NOT TO BE USED IN ANY WAY DETRIMENTAL TO THE INTEREST OF SUTPHEN CORPORATION.

SUTPHEN CORPORATION
FIRE APPARATUS SINCE 1890
7000 COLUMBUS-MARYSVILLE ROAD
AMLIN, OHIO 43002

**ELKHART
FIRE DEPARTMENT**

BODY SIZE: 26' BODY	UNIT TYPE: HEAVY RESCUE / WALK-IN
BODY MATERIAL: 3/16" ALUMINUM	TRUCK NO: SVI #1216
CHASSIS TYPE: SUTPHEN	WHEELBASE: 263.00"
MONARCH 73"	CAB TO AXLE: 190.00"
20" RR	OVERALL LENGTH (OAL): 489.00"
FOUR DOOR	OVERALL WIDTH (OAW): 100.00"
	OVERALL HEIGHT (OAH): 135.00"

DRAWN BY: KP DATE: February 7, 2023 SCALE: 3/16" = 1'-0"

DRAWING NO: Elkhart IN wt 26 AsBuilt SHEET 3 OF 3